



01 WAREHOUSE FLOOR PLAN  
 A1 SCALE 1 : 110MTS

<b>A.V.MESIONA CONSTRUCTION INC.</b>	<b>ARCHITECT/ENGINEER</b>		R.A 9266	<b>PROJECT</b>	OWNER	<b>SHEET CONTENT</b>	<b>REVISION No.:</b>	<b>CHECKED BY:</b>	<b>SHEET No.:</b>	
	<small>DRAWINGS AND SPECIFICATIONS DULY SIGNED, STAMPED AND SEALED AS INSTRUMENT OF SERVICES ARE PROPERTY AND DOCUMENTS OF THE ARCHITECT WHETHER THE OBJECT FOR WHICH THEY ARE MADE ARE EXECUTED OR NOT. IT SHALL BE UNLAWFUL FOR ANY PERSON WITHOUT WRITTEN CONSENT OF THE ARCHITECT OF SAID DOCUMENTS TO DUPLICATE OR TO MAKE COPIES FOR USE IN REPIITITION OF AND OTHER PROJECTS OR BUILDINGS WHETHER EXECUTED PARTLY OR IN WHOLE.</small>			AS-BUILT WAREHOUSE						
	<small>PRC. REG. No.:</small> <small>PTR No.:</small> <small>DATE ISSUED:</small> <small>PLACE ISSUED:</small>	<small>TIN No.:</small> <small>IAPOA No.:</small> <small>DATE ISSUED:</small> <small>PLACE ISSUED:</small>		<b>LOCATION</b>						
				SALCEDO VILLAGE ROAD, CAGAYAN DE ORO CITY						
									<b>CADD BY:</b>	<b>REVISION No.:</b>

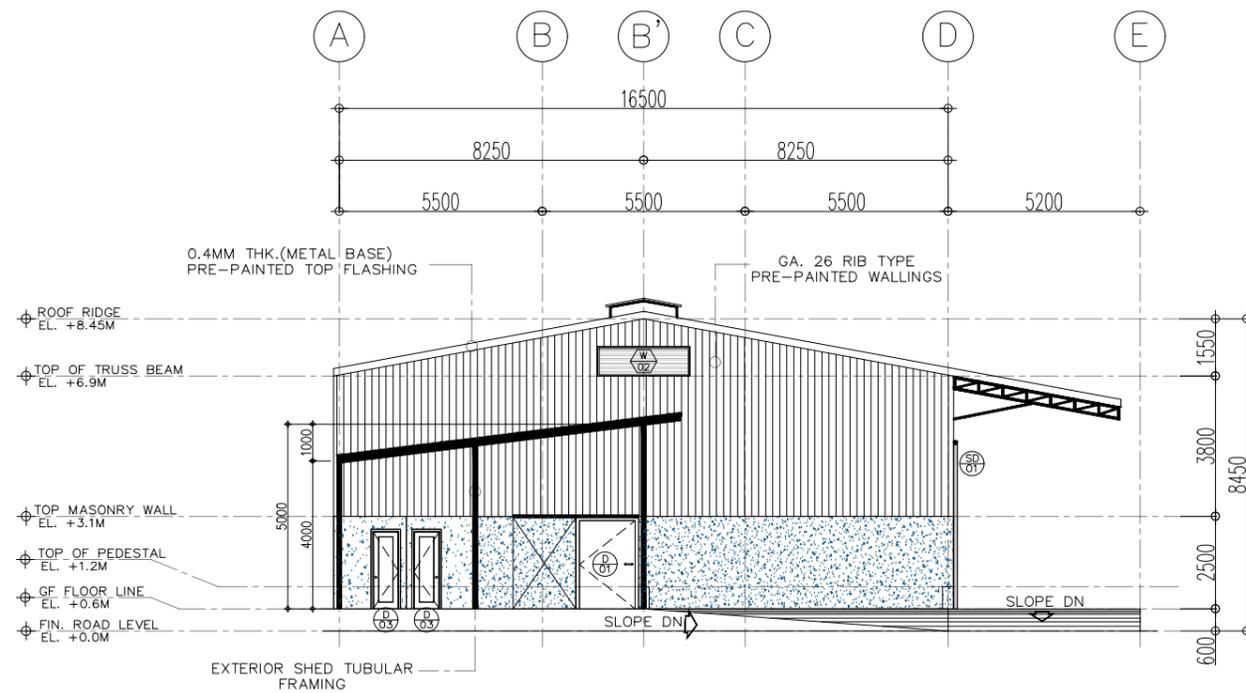

02 FRONT ELEVATION  
A2 SCALE 1 : 100MTS

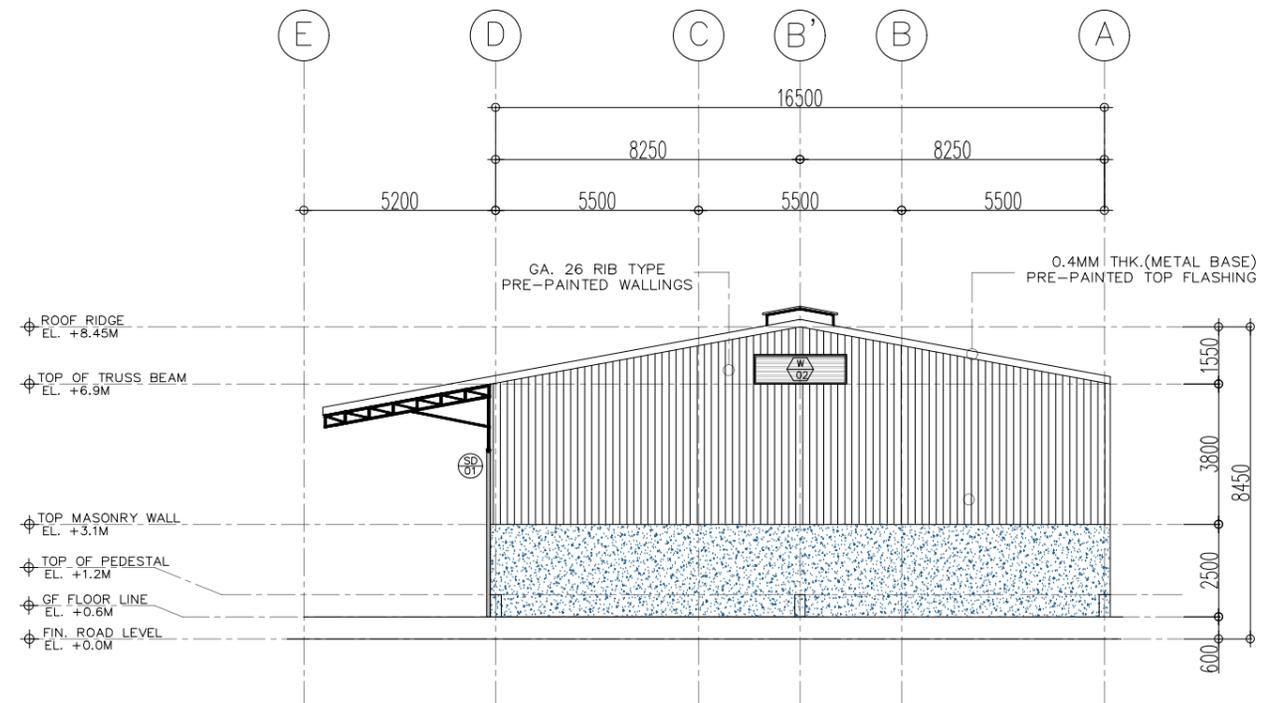

03 REAR SIDE ELEVATION  
A2 SCALE 1 : 100MTS


A.V.MESIONA  
CONSTRUCTION INC.

ARCHITECT/ENGINEER		R.A 9266
PRC. REG. No.:	TIN No.:	DRAWINGS AND SPECIFICATIONS DULY SIGNED, STAMPED AND SEALED AS INSTRUMENT OF SERVICES ARE PROPERTY AND DOCUMENTS OF THE ARCHITECT WHETHER THE OBJECT FOR WHICH THEY ARE MADE ARE EXECUTED OR NOT. IT SHALL BE UNLAWFUL FOR ANY PERSON WITHOUT WRITTEN CONSENT OF THE ARCHITECT OF SAID DOCUMENTS TO DUPLICATE OR TO MAKE COPIES FOR USE IN REPIITION OF AND OTHER PROJECTSOR BUILDINGS WHETHER EXECUTED PARTLY OR IN WHOLE.
PTR No.:	IAPOA No.:	
DATE ISSUED:	DATE ISSUED:	
PLACE ISSUED:	PLACE ISSUED:	


DRAWINGS AND SPECIFICATIONS DULY SIGNED, STAMPED AND SEALED AS INSTRUMENT OF SERVICES ARE PROPERTY AND DOCUMENTS OF THE ARCHITECT WHETHER THE OBJECT FOR WHICH THEY ARE MADE ARE EXECUTED OR NOT. IT SHALL BE UNLAWFUL FOR ANY PERSON WITHOUT WRITTEN CONSENT OF THE ARCHITECT OF SAID DOCUMENTS TO DUPLICATE OR TO MAKE COPIES FOR USE IN REPIITION OF AND OTHER PROJECTSOR BUILDINGS WHETHER EXECUTED PARTLY OR IN WHOLE.

PROJECT	AS-BUILT WAREHOUSE
LOCATION	SALCEDO VILLAGE ROAD, CAGAYAN DE ORO CITY

OWNER	SHEET CONTENT	REVISION No.:	CHECKED BY:	SHEET No.:
			CADD BY:	REVISION No.:

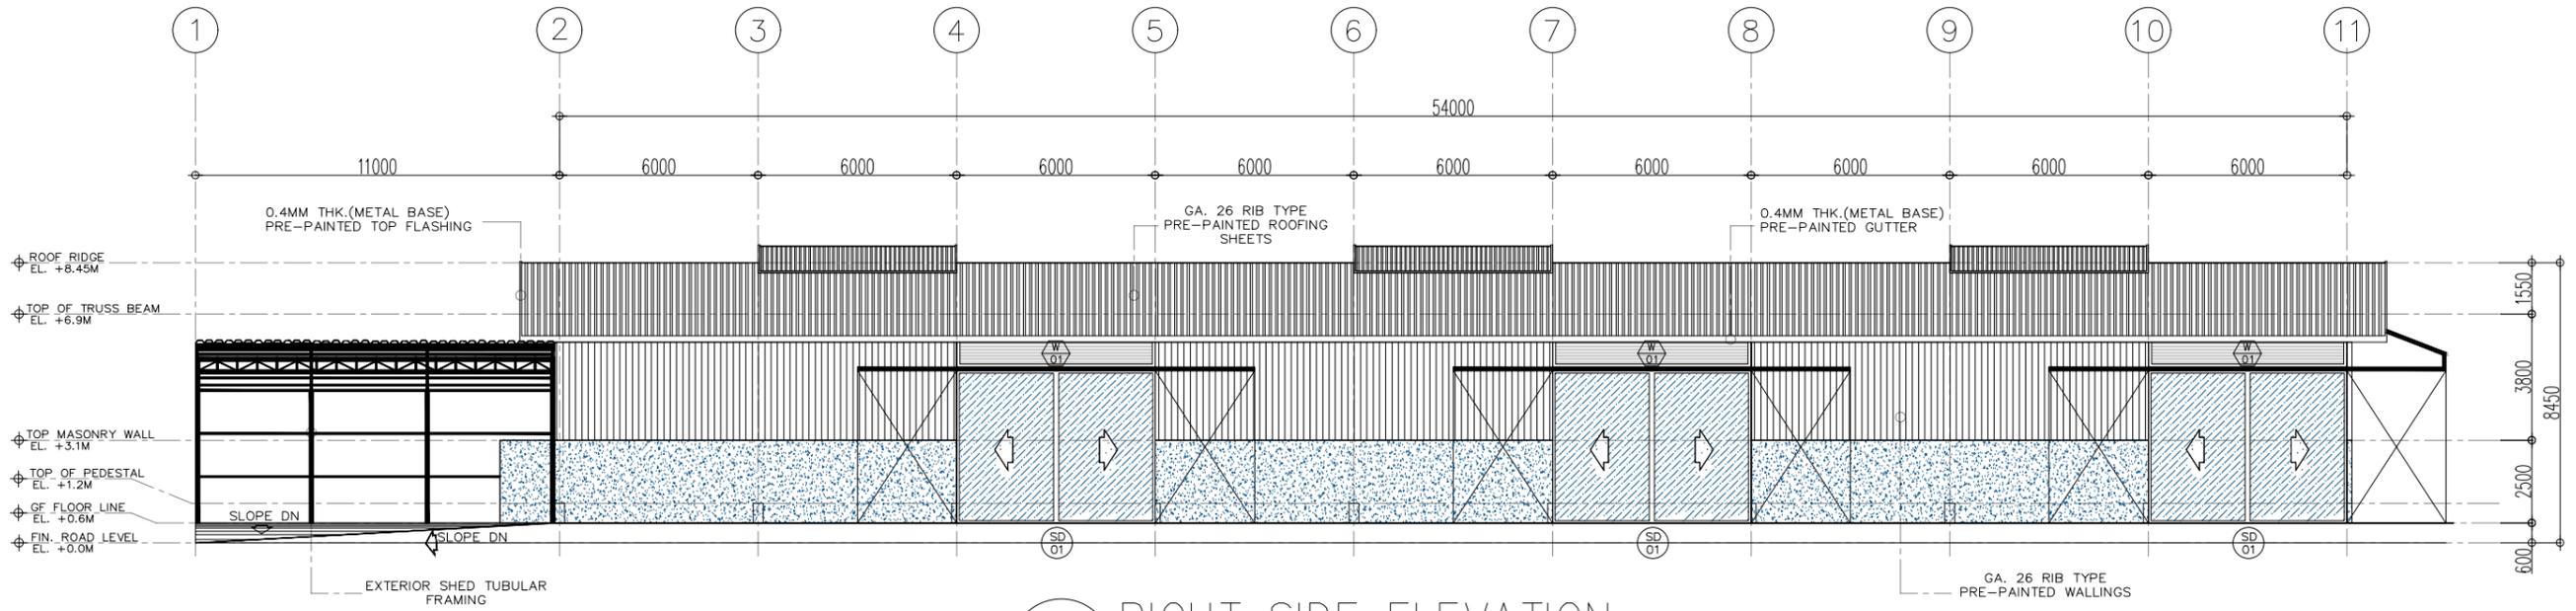


04 RIGHT SIDE ELEVATION  
 A3 SCALE 1 : 110MTS

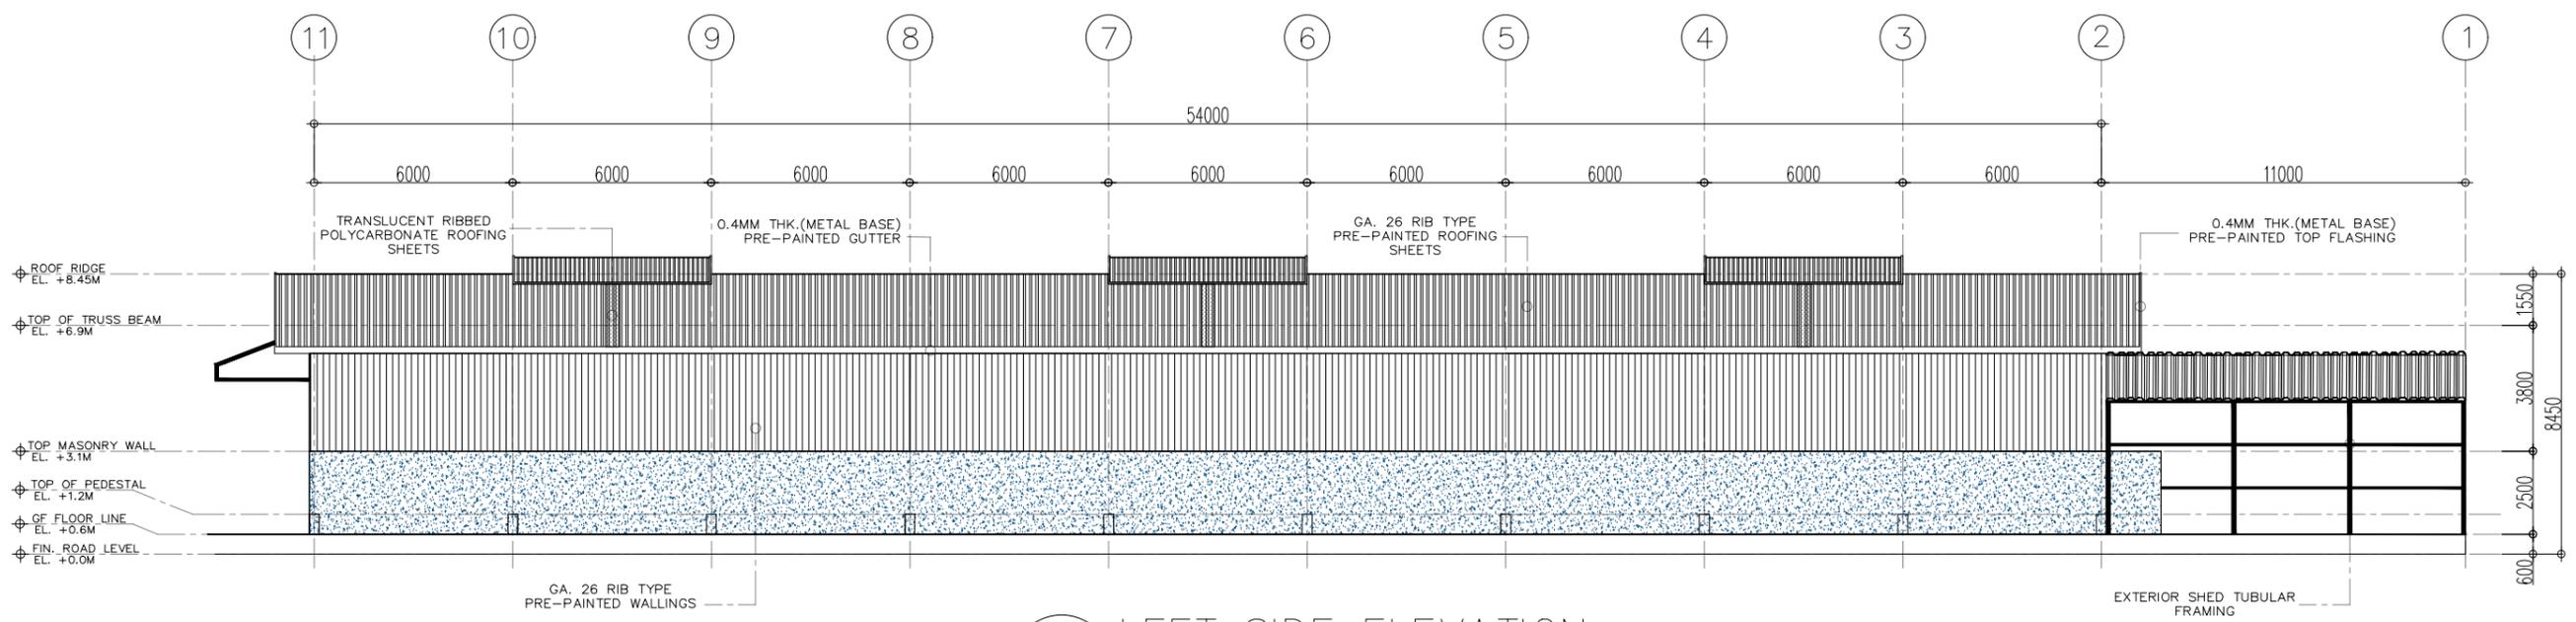


05 LEFT SIDE ELEVATION  
 A3 SCALE 1 : 110MTS

<b>A.V.MESIONA CONSTRUCTION INC.</b>	ARCHITECT/ENGINEER		R.A 9266	PROJECT	OWNER	SHEET CONTENT	REVISION No.:	CHECKED BY:	SHEET No.:	
			DRAWINGS AND SPECIFICATIONS DULY SIGNED, STAMPED AND SEALED AS INSTRUMENT OF SERVICES ARE PROPERTY AND DOCUMENTS OF THE ARCHITECT WHETHER THE OBJECT FOR WHICH THEY ARE MADE ARE EXECUTED OR NOT. IT SHALL BE UNLAWFUL FOR ANY PERSON WITHOUT WRITTEN CONSENT OF THE ARCHITECT OF SAID DOCUMENTS TO DUPLICATE OR TO MAKE COPIES FOR USE IN REPIITTION OF AND OTHER PROJECTS OR BUILDINGS WHETHER EXECUTED PARTLY OR IN WHOLE.	AS-BUILT WAREHOUSE						
				LOCATION						
				SALCEDO VILLAGE ROAD, CAGAYAN DE ORO CITY						
	PRC. REG. No.:	TIN No.:								
PTR No.:	IAPOA No.:									
DATE ISSUED:	DATE ISSUED:									
PLACE ISSUED:	PLACE ISSUED:									
								CADD BY:	REVISION No.:	

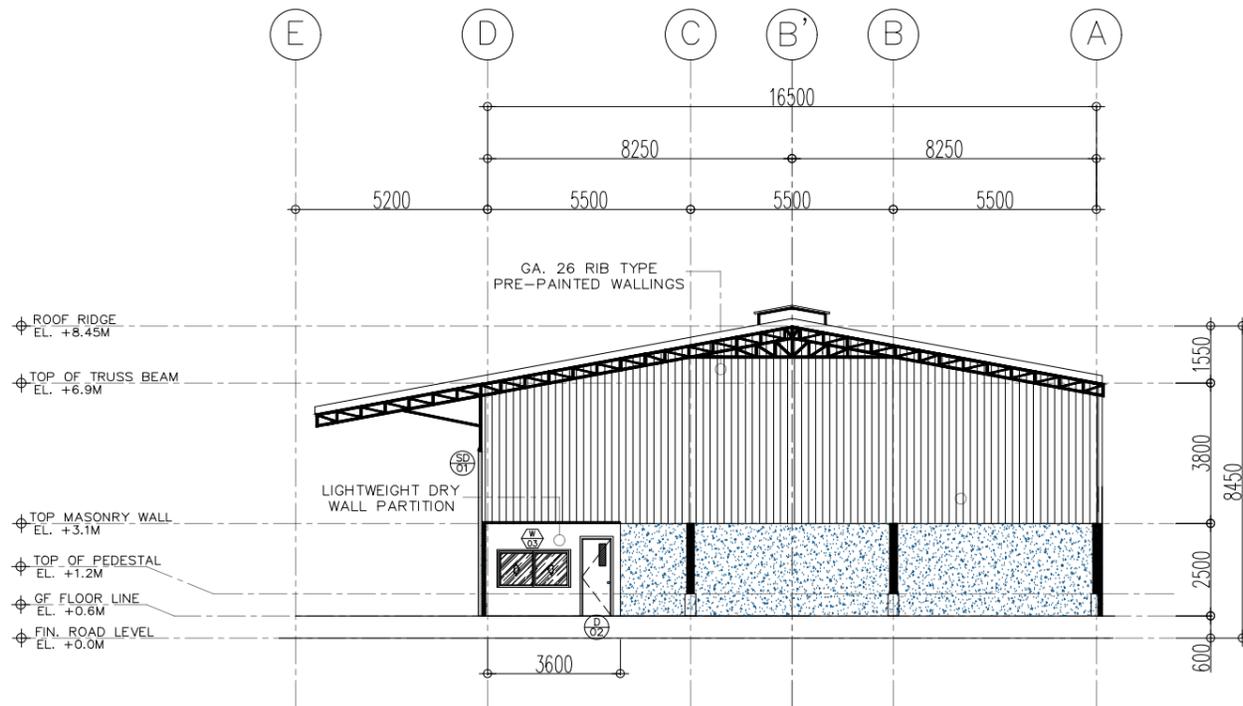

06 TRANSVERSE SECTION A-A  
A4 SCALE 1 : 100MTS

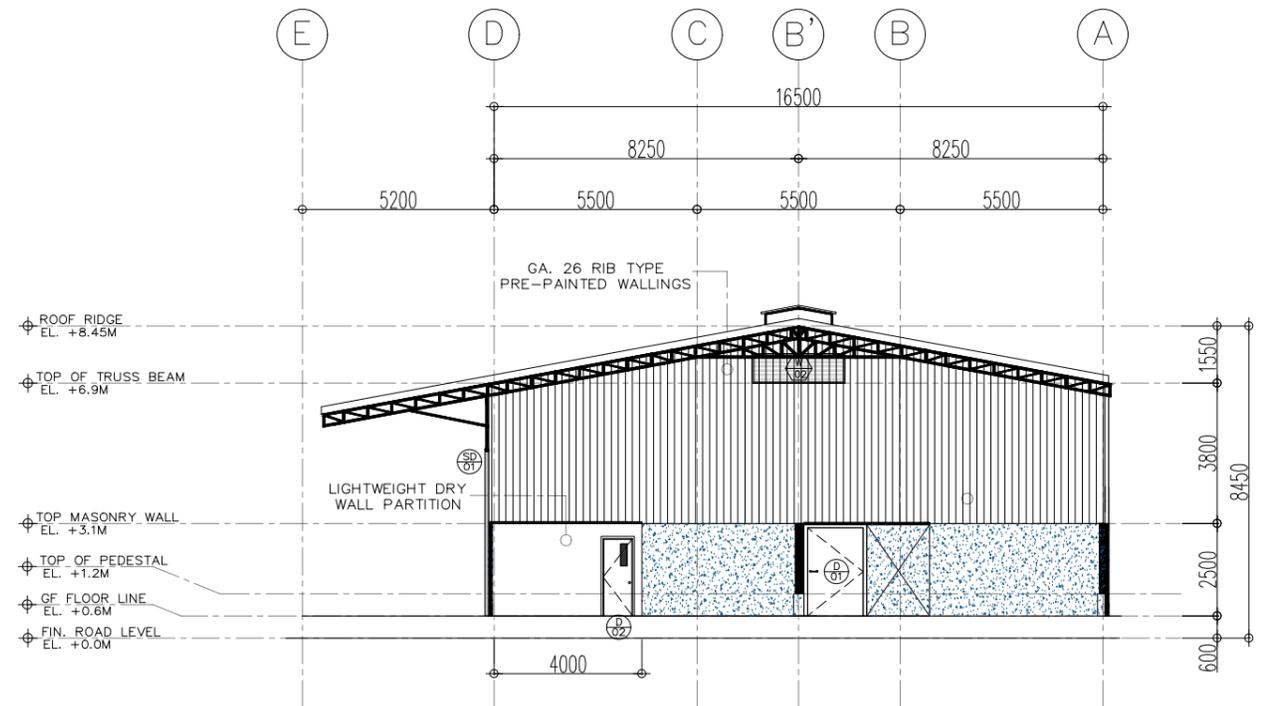


07 TRANSVERSE SECTION B-B  
A4 SCALE 1 : 100MTS

A.V.MESIONA  
CONSTRUCTION INC.


ARCHITECT/ENGINEER		R.A 9266
PRC. REG. No.:	TIN No.:	DRAWINGS AND SPECIFICATIONS DULY SIGNED, STAMPED AND SEALED AS INSTRUMENT OF SERVICES ARE PROPERTY AND DOCUMENTS OF THE ARCHITECT WHETHER THE OBJECT FOR WHICH THEY ARE MADE ARE EXECUTED OR NOT. IT SHALL BE UNLAWFUL FOR ANY PERSON WITHOUT WRITTEN CONSENT OF THE ARCHITECT OF SAID DOCUMENTS TO DUPLICATE OR TO MAKE COPIES FOR USE IN REPIITITION OF AND OTHER PROJECTS OR BUILDINGS WHETHER EXECUTED PARTLY OR IN WHOLE.
PTR No.:	IAPOA No.:	
DATE ISSUED:	DATE ISSUED:	
PLACE ISSUED:	PLACE ISSUED:	

PROJECT	AS-BUILT WAREHOUSE
LOCATION	SALCEDO VILLAGE ROAD, CAGAYAN DE ORO CITY

OWNER	SHEET CONTENT	REVISION No.:	CHECKED BY:	SHEET No.:
			CADD BY:	REVISION No.:

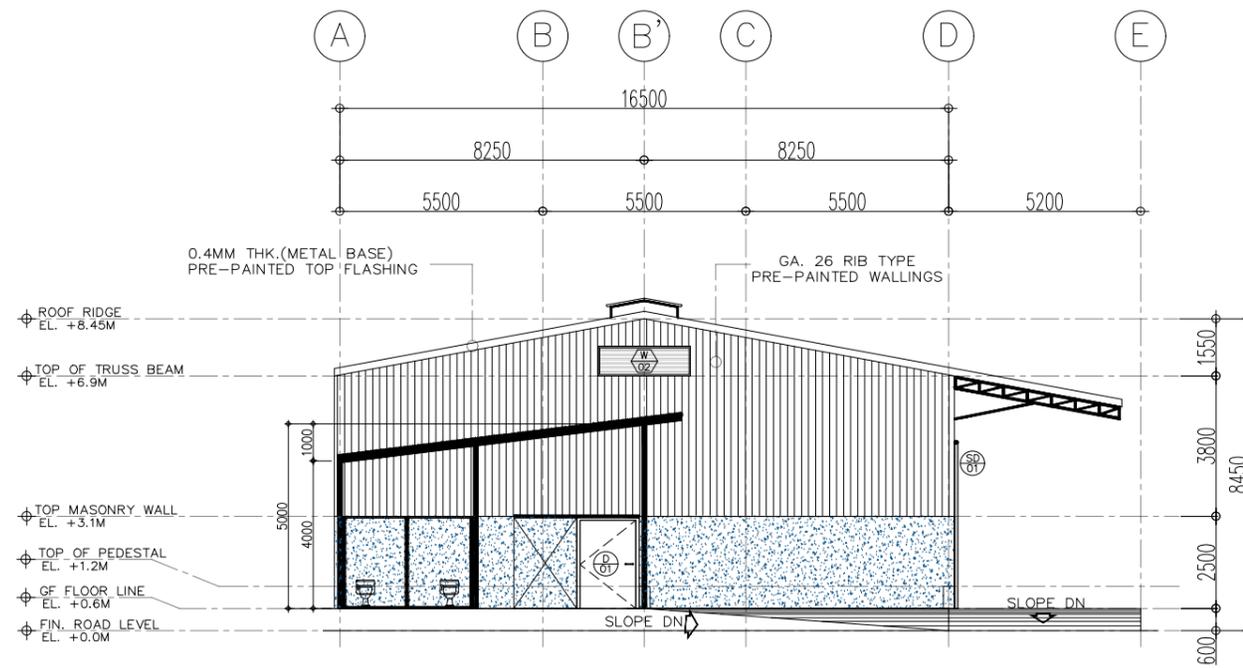

08 TRANSVERSE SECTION C-C  
A5 SCALE 1 : 100MTS

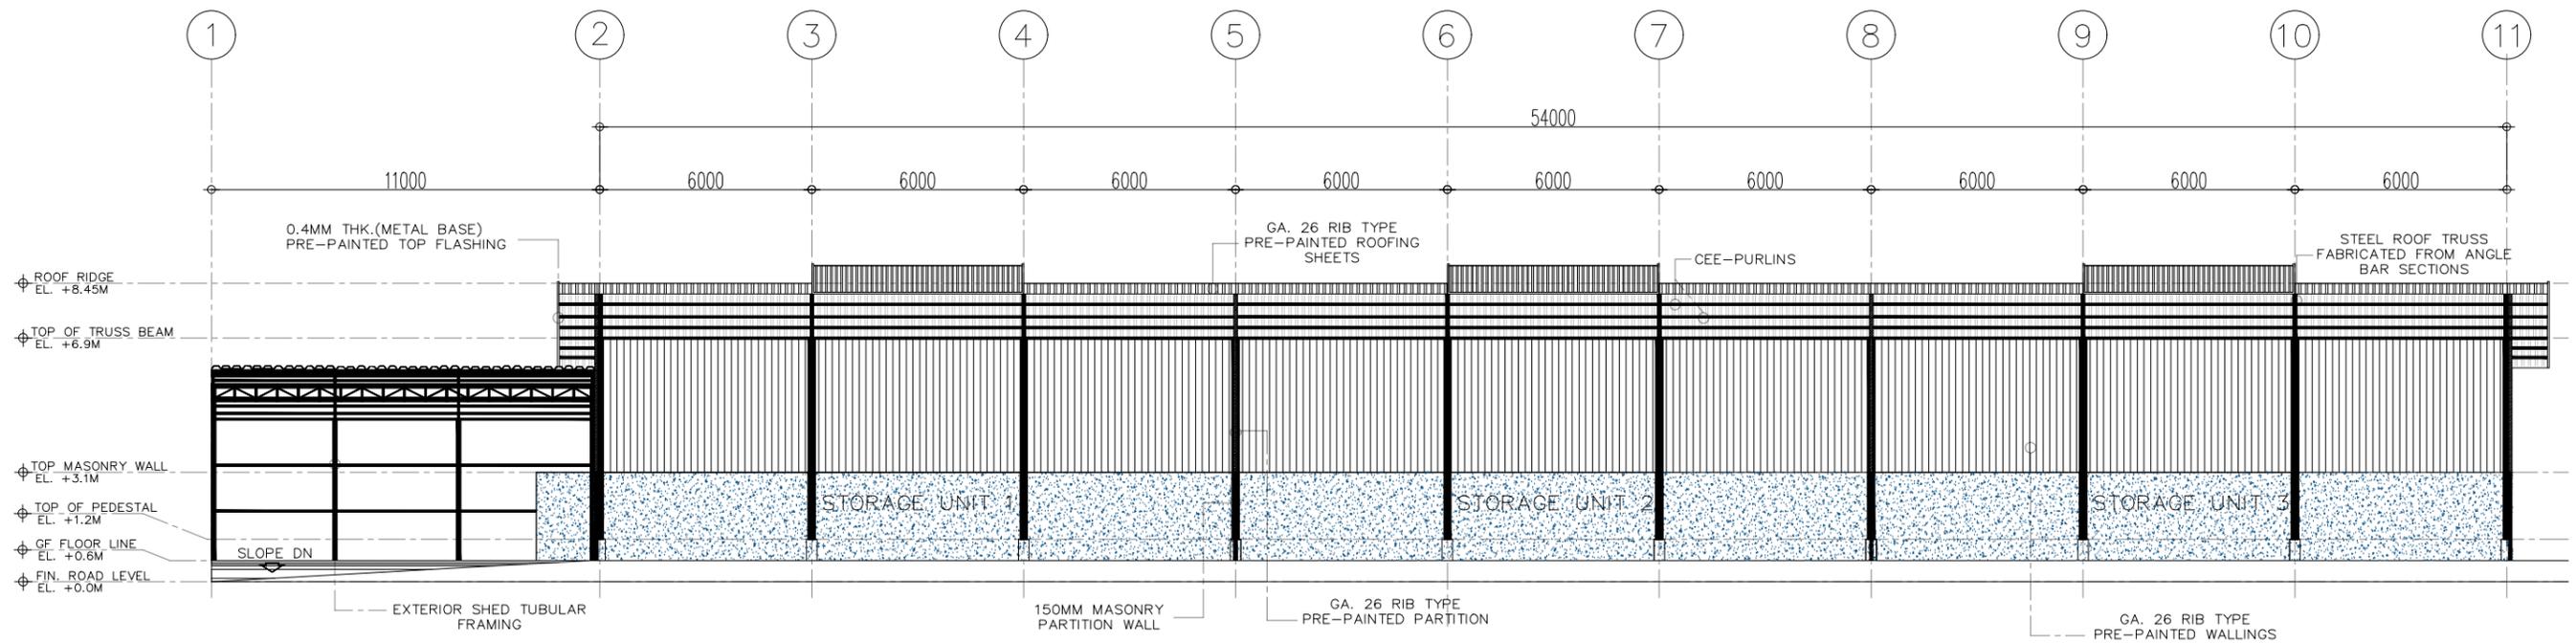

09 LONGITUDINAL SECTION D-D  
A5 SCALE 1 : 100MTS

A.V.MESIONA  
CONSTRUCTION INC.

ARCHITECT/ENGINEER	R.A 9266	PROJECT	OWNER	SHEET CONTENT	REVISION No.:	CHECKED BY:	SHEET No.:
PRC. REG. No.: PTR No.: DATE ISSUED: PLACE ISSUED:	TIN No.: IAPOA No.: DATE ISSUED: PLACE ISSUED:	AS-BUILT WAREHOUSE LOCATION SALCEDO VILLAGE ROAD, CAGAYAN DE ORO CITY					
<small>DRAWINGS AND SPECIFICATIONS DULY SIGNED, STAMPED AND SEALED AS INSTRUMENT OF SERVICES ARE PROPERTY AND DOCUMENTS OF THE ARCHITECT WHETHER THE OBJECT FOR WHICH THEY ARE MADE ARE EXECUTED OR NOT. IT SHALL BE UNLAWFUL FOR ANY PERSON WITHOUT WRITTEN CONSENT OF THE ARCHITECT OF SAID DOCUMENTS TO DUPLICATE OR TO MAKE COPIES FOR USE IN REPIITTION OF AND OTHER PROJECTS OR BUILDINGS WHETHER EXECUTED PARTLY OR IN WHOLE.</small>							
						CADD BY:	REVISION No.: